
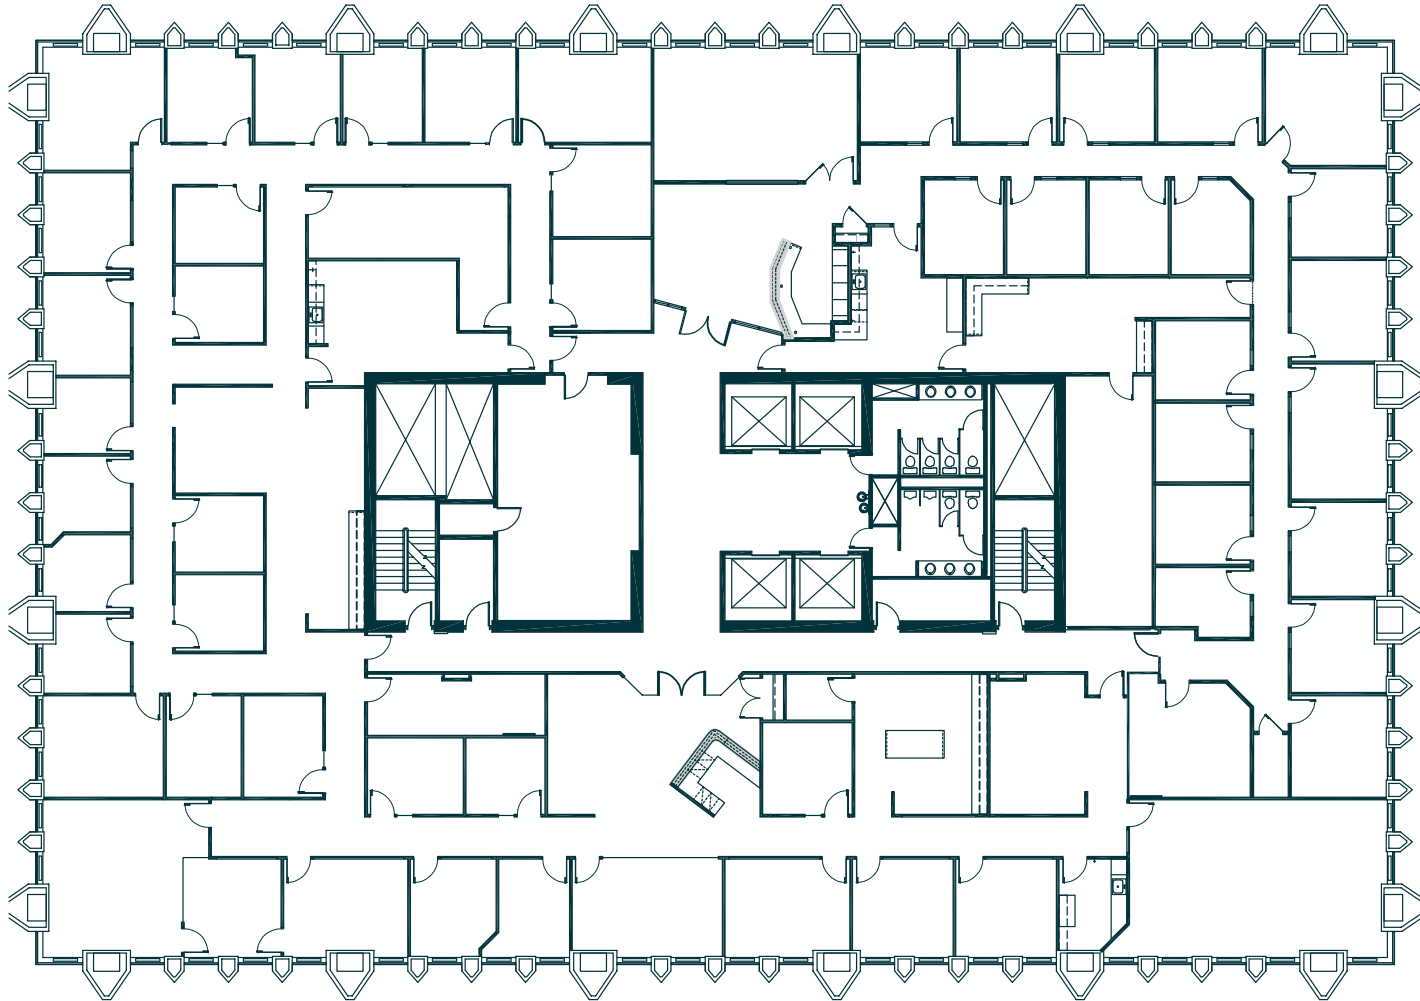


INDEPENDENCE — PLAZA —

Office Tower


Suite 2200 - 19,167 SF
AS-BUILT

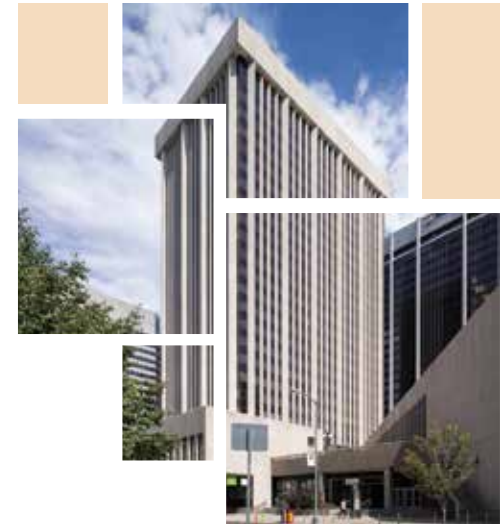

Notes

- Reception
- 31 perimeter offices; 20 interior
- 5 conference rooms
- Kitchen / break room
- File / copy room
- Mens & Women's restrooms

Key Plan

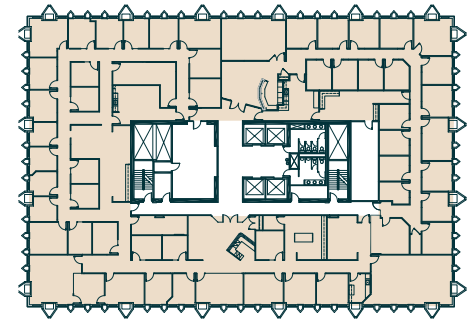

To schedule your tour, contact the leasing team:

MICHAEL CRANE
+1 303 260 6533
michael.crane@am.jll.com

ANDY ROSS
+1 303 260 6504
andy.ross@am.jll.com


Jones Lang LaSalle Brokerage, Inc.

HEITMAN
A REAL ESTATE INVESTMENT MANAGEMENT FIRM