
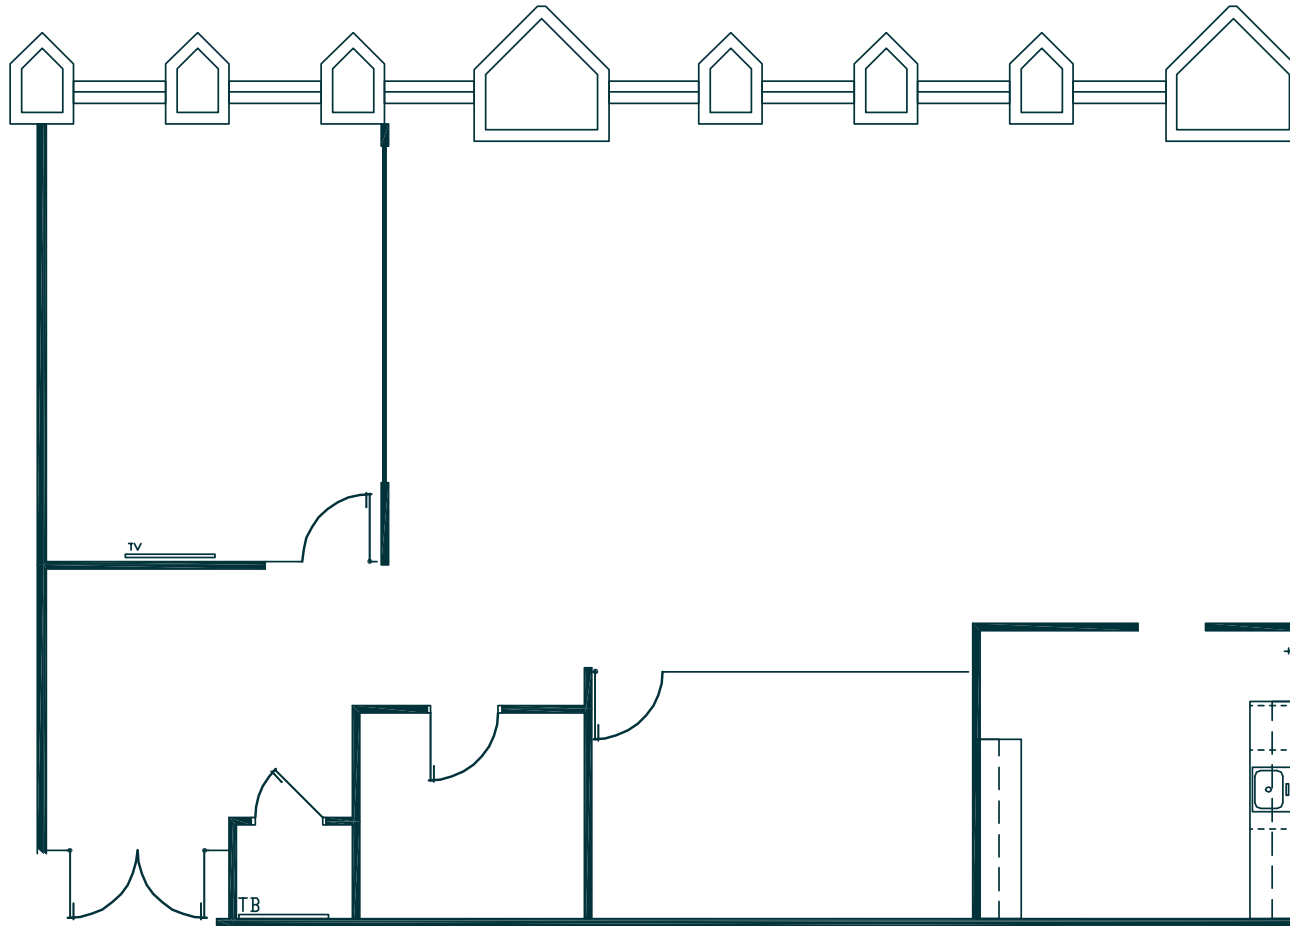


# INDEPENDENCE — PLAZA —

## Office Tower


Suite 2450 - 2,448 SF  
AS-BUILT

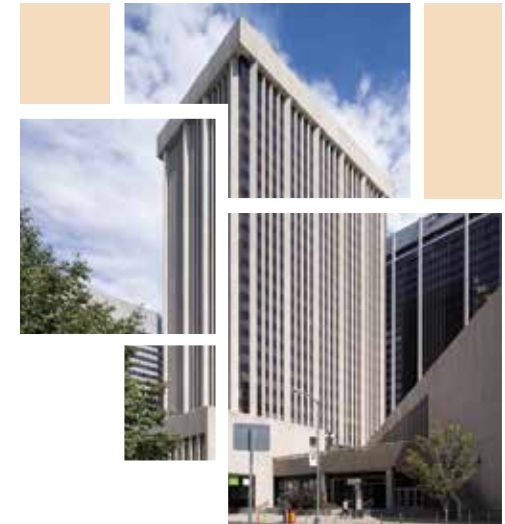

### Notes

- Reception
- 1 office
- Conference room
- Kitchen / break room
- Open space for workstations

### Key Plan

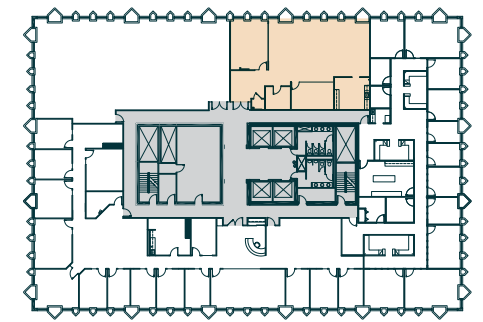

To schedule your tour, contact the leasing team:

**MICHAEL CRANE**  
+1 303 260 6533  
michael.crane@am.jll.com

**ANDY ROSS**  
+1 303 260 6504  
andy.ross@am.jll.com

  
Jones Lang LaSalle Brokerage, Inc.

**HEITMAN**  
A REAL ESTATE INVESTMENT MANAGEMENT FIRM