



INDEPENDENCE — PLAZA —

Office Tower

Suite 2500 - 19,706 SF
AS-BUILT

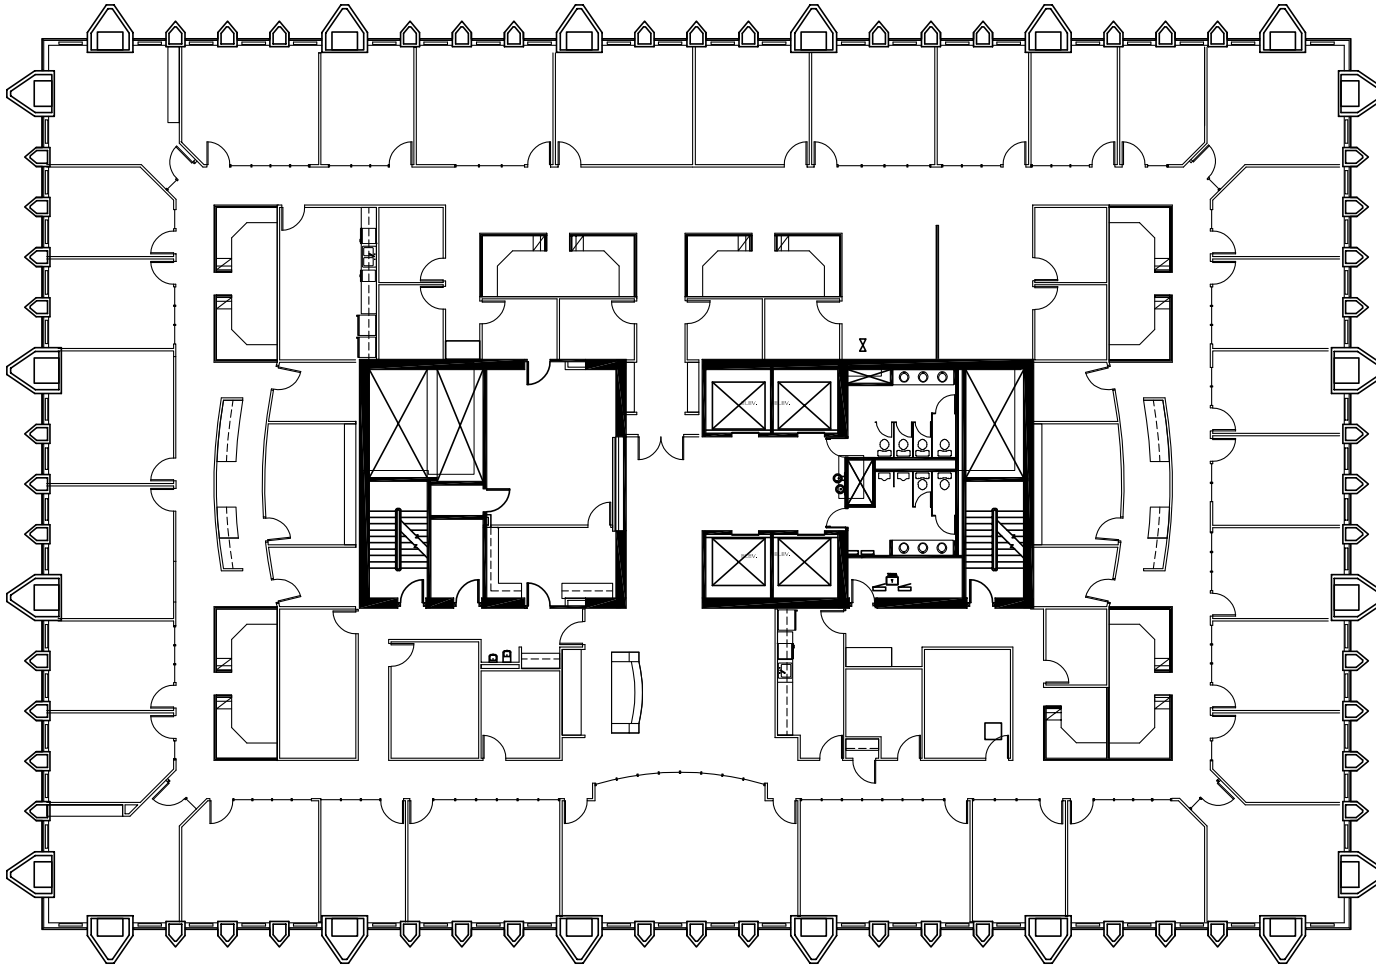

Key Plan

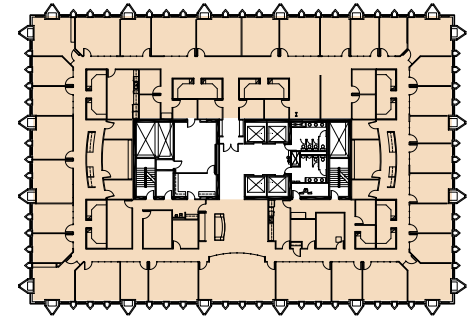

To schedule your tour, contact the leasing team:

MICHAEL CRANE
+1 303 260 6533
michael.crane@am.jll.com

ANDY ROSS
+1 303 260 6504
andy.ross@am.jll.com


Jones Lang LaSalle Brokerage, Inc.

HEITMAN
A REAL ESTATE INVESTMENT MANAGEMENT FIRM