


# INDEPENDENCE — PLAZA —

## Annex Building A


3rd Floor - 28,886 SF  
AS-BUILT

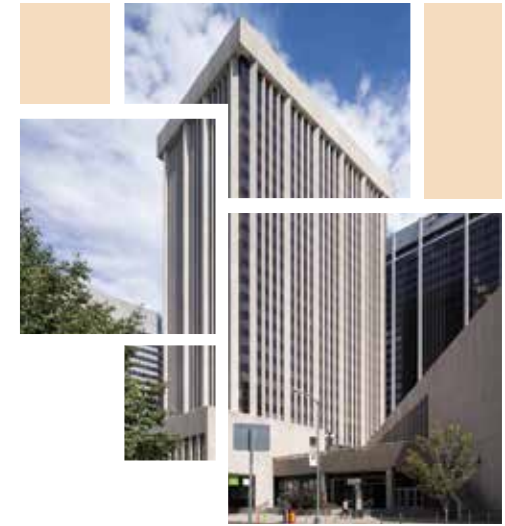

### Notes

- Two dedicated Annex Building A elevators
- 12 small huddle rooms
- 11 medium conference rooms
- 2 large conference rooms
- Break room
- Private restrooms
- Interconnecting stairwell

### Key Plan

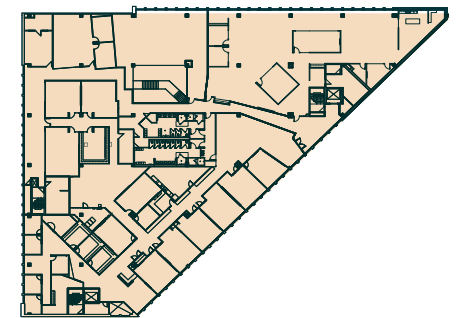

To schedule your tour, contact the leasing team:

**MICHAEL CRANE**  
+1 303 260 6533  
michael.crane@am.jll.com

**ANDY ROSS**  
+1 303 260 6504  
andy.ross@am.jll.com

  
Jones Lang LaSalle Brokerage, Inc.

**HEITMAN**  
A REAL ESTATE INVESTMENT MANAGEMENT FIRM