
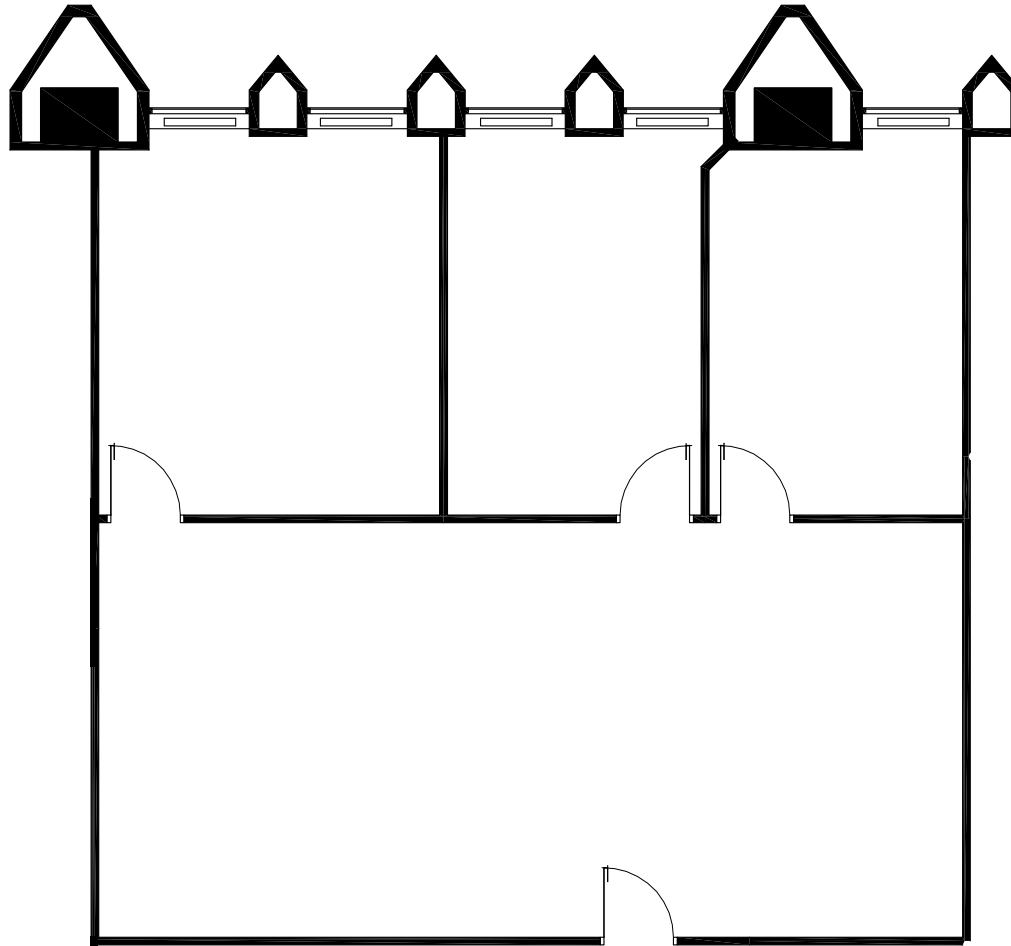



INDEPENDENCE — PLAZA —

Office Tower

Suite 1705 - 1,609 SF
AS-BUILT

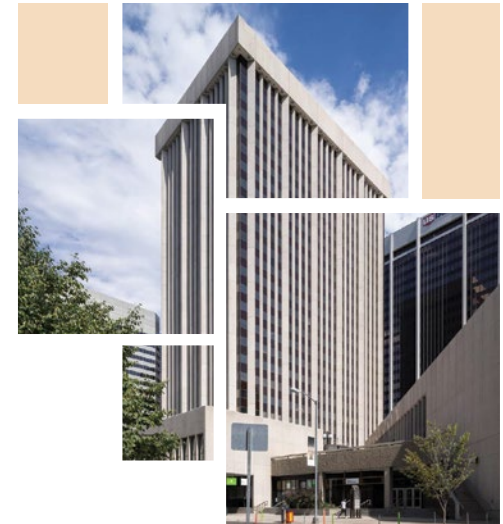

Key Plan

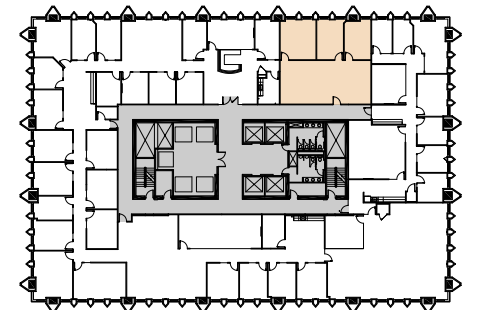

To schedule your tour, contact the leasing team:

MICHAEL CRANE
+1 303 260 6533
michael.crane@am.jll.com

ANDY ROSS
+1 303 260 6504
andy.ross@am.jll.com



Jones Lang LaSalle Brokerage, Inc.

