


INDEPENDENCE — PLAZA —

Office Tower



Suite 2400 - 7,140 SF
AS-BUILT

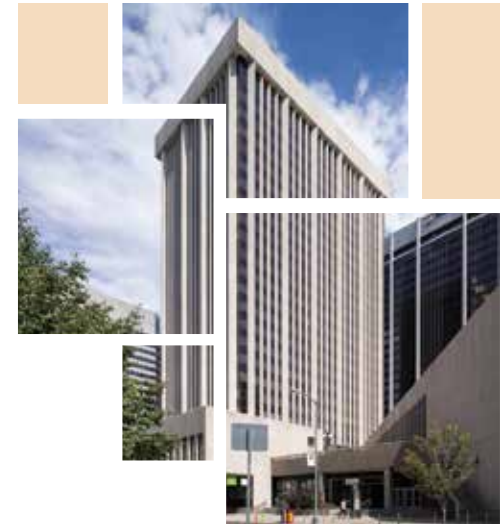

Notes

- Reception
- Perimeter offices
- Conference rooms
- Kitchen / break area
- File / copy room

Key Plan

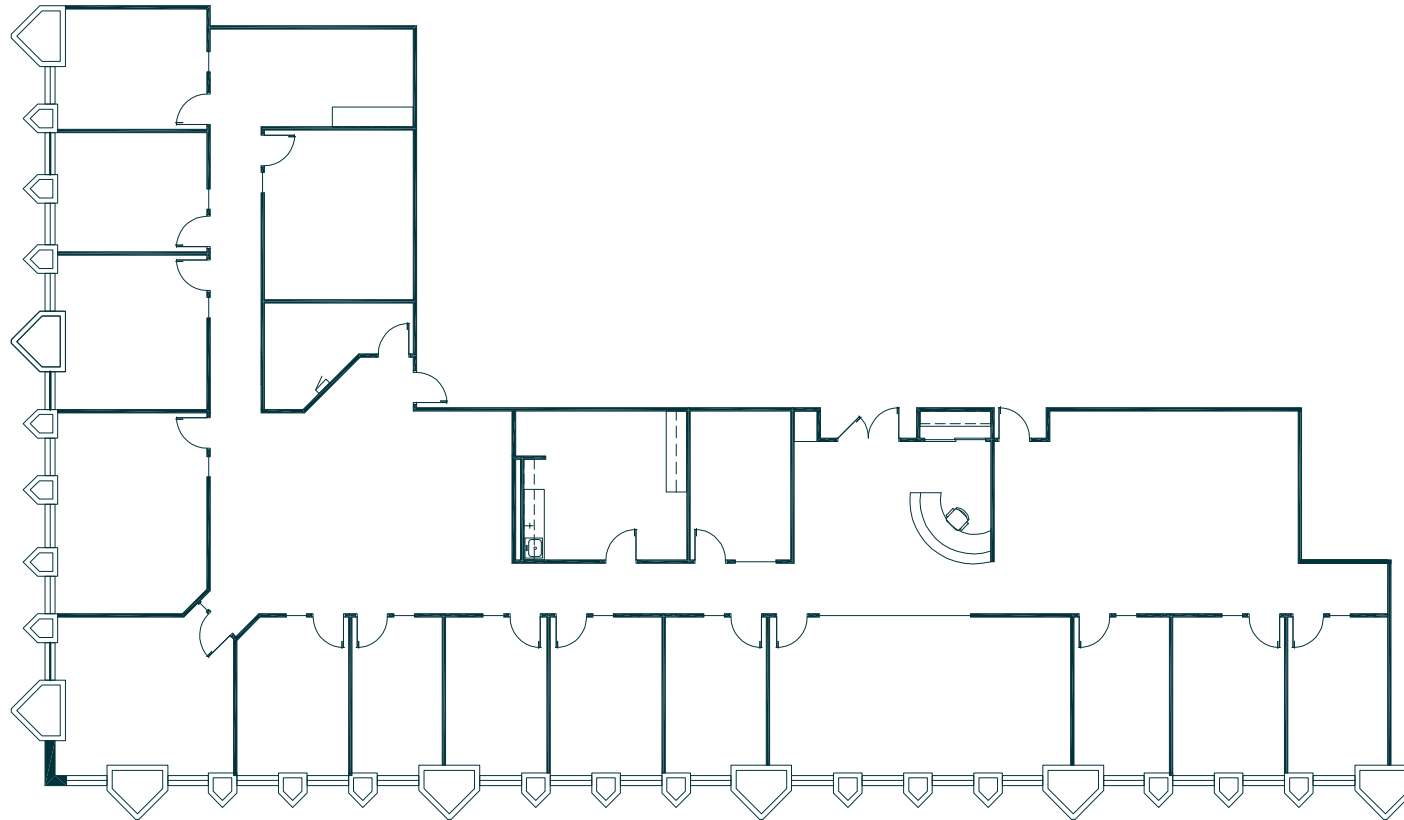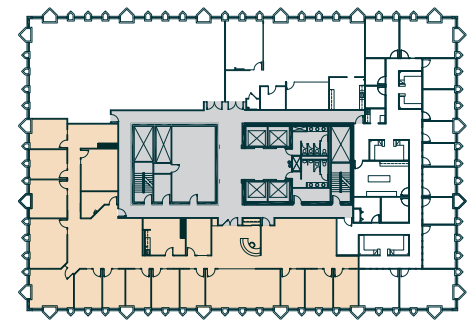

To schedule your tour, contact the leasing team:

MICHAEL CRANE
+1 303 260 6533
michael.crane@am.jll.com

ANDY ROSS
+1 303 260 6504
andy.ross@am.jll.com


Jones Lang LaSalle Brokerage, Inc.

HEITMAN
A REAL ESTATE INVESTMENT MANAGEMENT FIRM